



Control Number: 43360



Item Number: 38

Addendum StartPage: 0



8611 Botts Lane
 San Antonio, Texas 78217
 ph - (210) 828-7070
 fx - (210) 828-7076

TRANSMITTAL FORM

To: Public Utility Commission of Texas
1701 N. Congress, P.O. Box 13326
Austin, Texas 78711

Date: 08/27/15
 Proj. No.: Docket # 43360
 Ref: City of Pleasanton

Attn: Filing Clerk

WE ARE SENDING YOU:

- | | |
|--|---|
| <input checked="" type="checkbox"/> Attached | <input type="checkbox"/> Under separate cover via the following items |
| <input type="checkbox"/> Shop Drawings | <input type="checkbox"/> Original Drawings |
| <input type="checkbox"/> Copy of letter | <input checked="" type="checkbox"/> Other |
| <input type="checkbox"/> Specifications | |
| <input type="checkbox"/> Submittal Data | |

RECEIVED
 2015 AUG 28 AM 10:48
 PUBLIC UTILITY COMMISSION
 FILING CLERK

No. of Copies	Description
10	REVISED MAPS BASED ON OPT OUTS (WATER & SEWER CCN)
1	DISC DIGITAL MAPPING DATA REVISED FOR OPT OUTS (WATER & SEWER CCN)

THESE ARE TRANSMITTED (as checked below):

- | | | |
|--|---|--|
| <input checked="" type="checkbox"/> For approval | <input type="checkbox"/> No exception taken | <input type="checkbox"/> Resubmit _____ copies for approval |
| <input type="checkbox"/> For your use | <input type="checkbox"/> Make corrections noted | <input type="checkbox"/> Submit _____ copies for distributions |
| <input checked="" type="checkbox"/> As requested | <input type="checkbox"/> Rejected | <input type="checkbox"/> Return _____ corrected prints |
| <input type="checkbox"/> For review and comment | | <input checked="" type="checkbox"/> For your distribution |

Remarks:


Responses - concerning Docket # 43360 - REVISED MAPS PER OPT OUTS RECEIVED.

NOTE: OPT OUT KENNETH DAVID MINNICH IS OUTSIDE OF PROPOSED CCN

Received by: _____

KLEIN ENGINEERING, INC.
 Brian M. Cope, P.E.

By: Brian M. Cope, P.E. 38

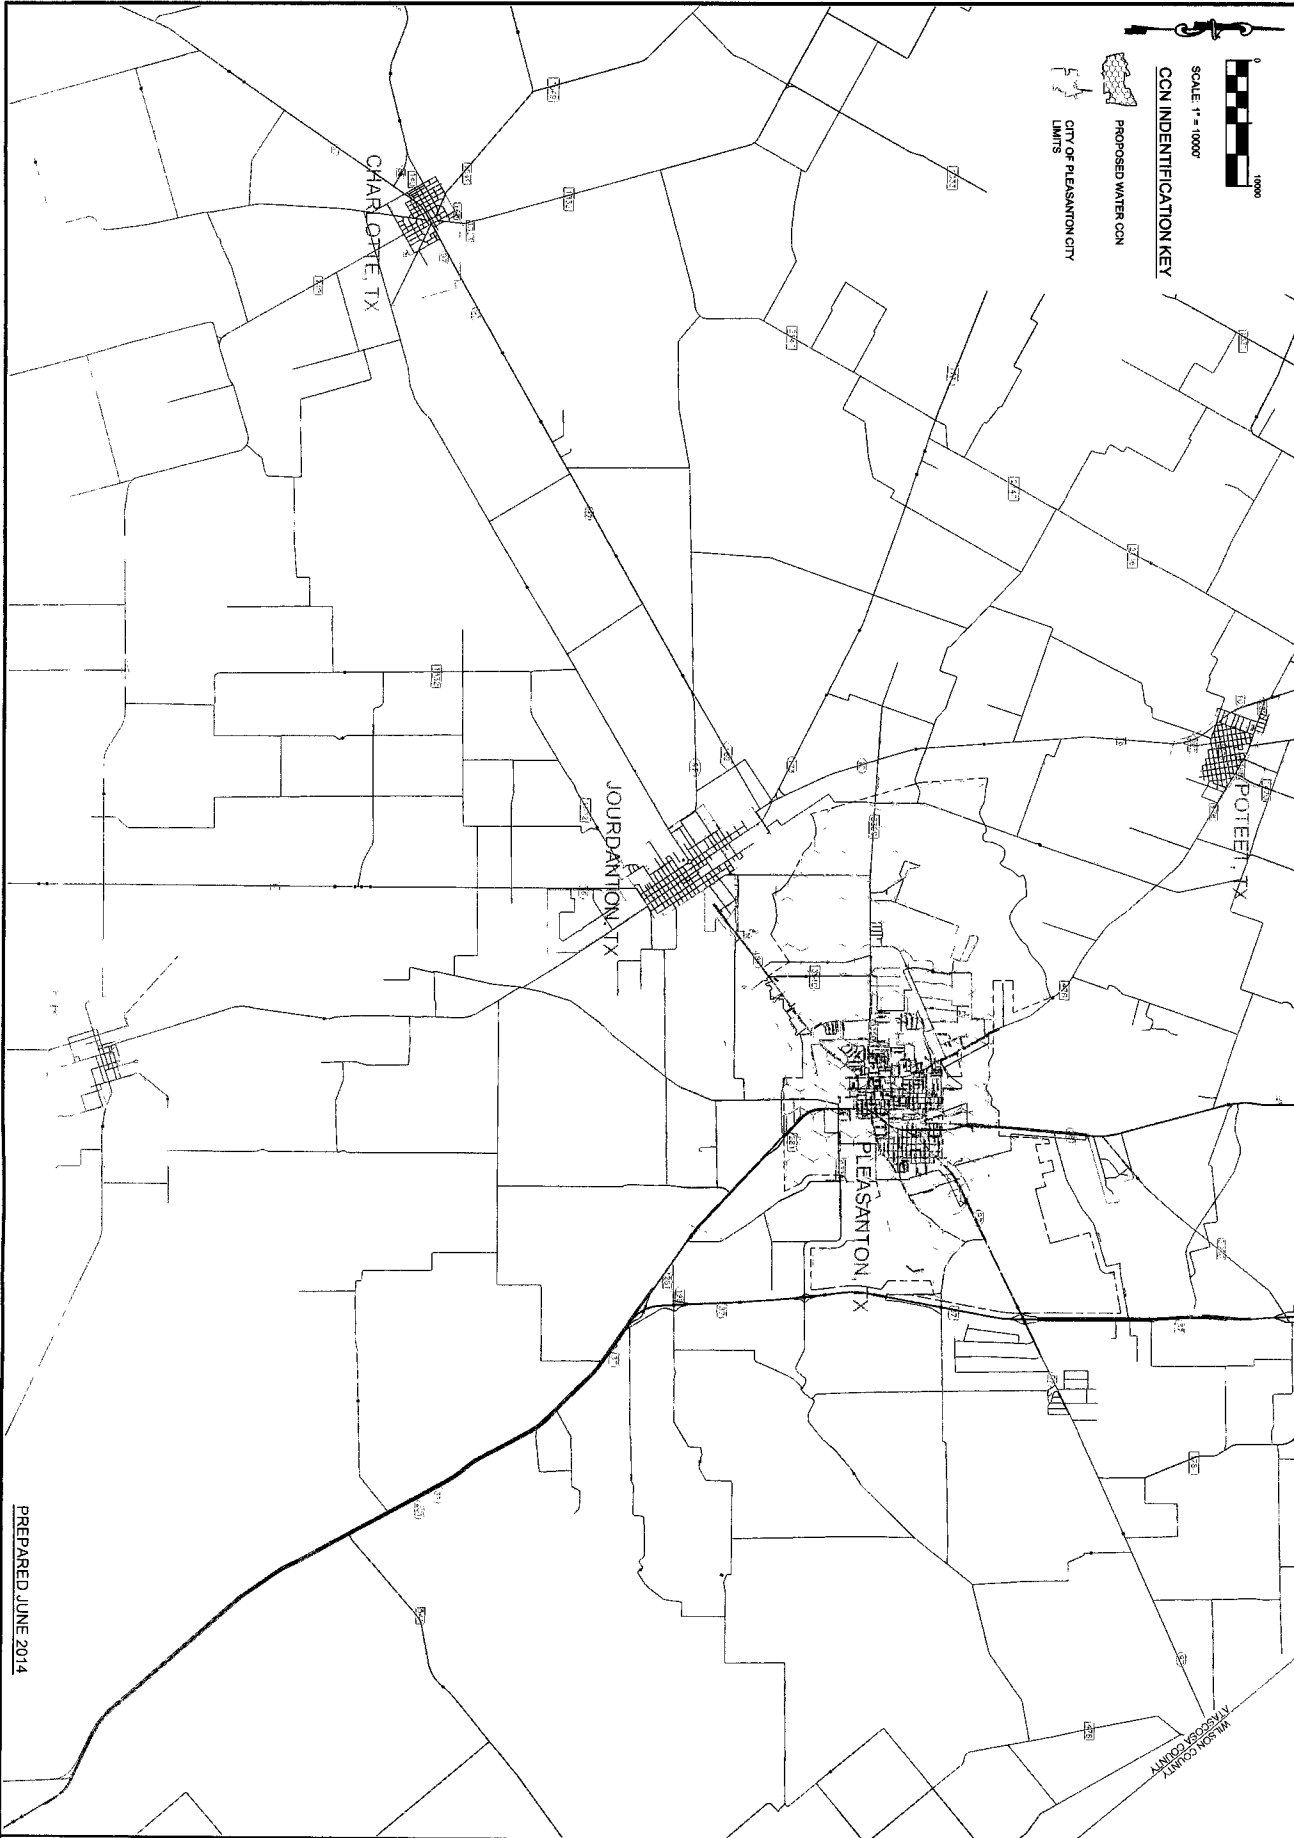


PREPARED JUNE 2014

JOB NO. JH17-22
 DATE 5/20/14
 DESIGNED BY: A.N.R.
 DRAWN BY: G.L.L.
 CHECKED BY: A.N.R.
 PAGE 1 OF 3

KLEIN & COPE ENGINEERING INC.
 CIVIL • MUNICIPAL • ENVIRONMENTAL ENGINEERS
 8011 BOYD LANE SAN ANTONIO, TEXAS 78217
 (214) 888-7070 FAX (214) 888-7076
 TEXAS REGISTRATION # P-16078

GENERAL LOCATION MAP - WATER
 PROPOSED CCN (WATER SERVICE) FOR THE CITY OF PLEASANTON

REVISIONS		
NO.	DESCRIPTION	DATE
1	OPT OUTS REMOVED	02/27/14

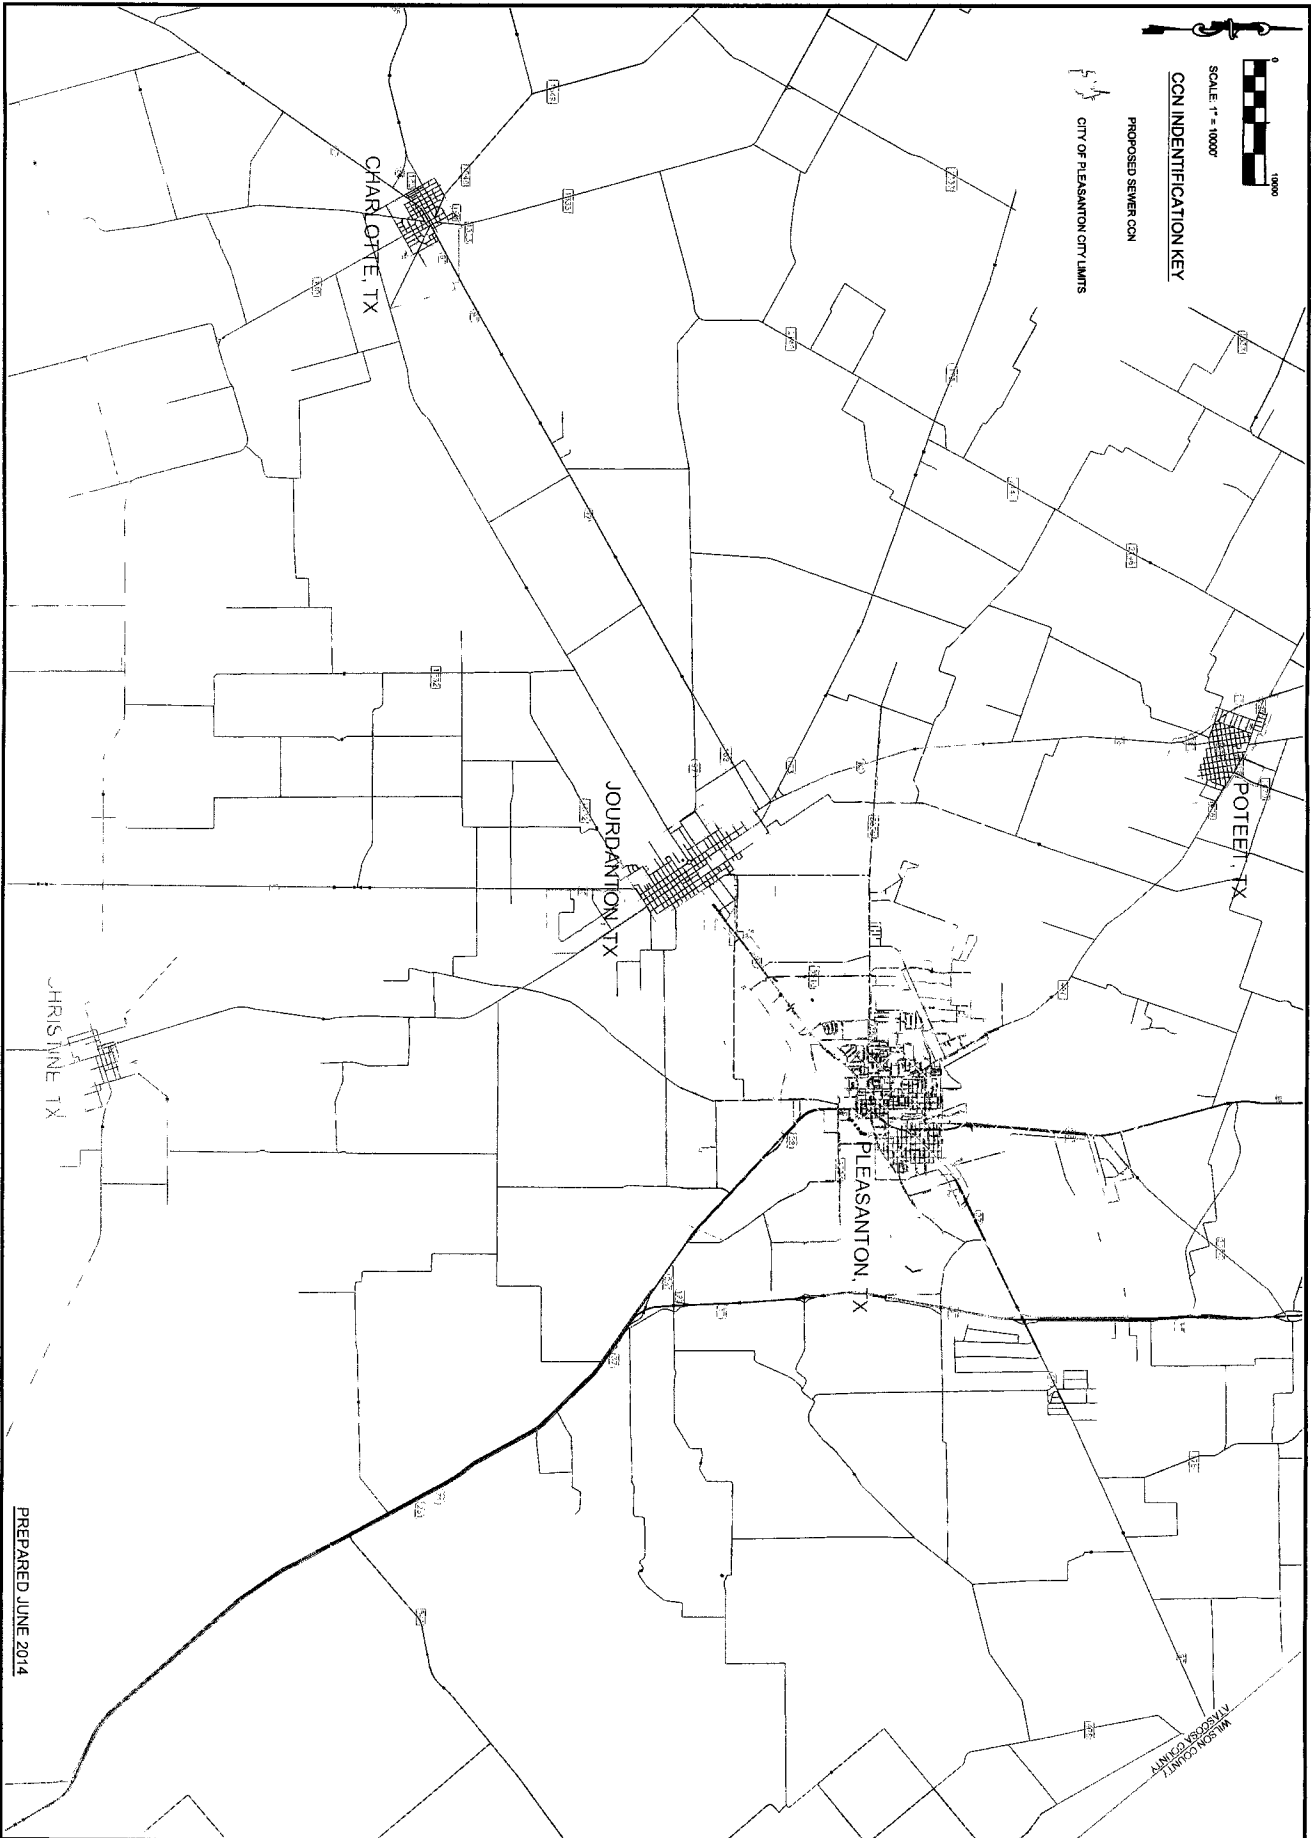

SCALE: 1" = 1000'

CCN IDENTIFICATION KEY

PROPOSED SENIOR CCN

CITY OF PLEASANTON CITY LIMITS

PREPARED JUNE 2014

KLEIN & COPE
ENGINEERING
INC.

CIVIL • MUNICIPAL • ENVIRONMENTAL ENGINEERS
8511 RYAN LANE SUITE 1000 NEW ANTONIO, TEXAS 78117
(210) 858-7070 FAX: (210) 858-7075
TEXAS REGISTRATION # F-19076


GENERAL LOCATION MAP - SEWER
PROPOSED CCN (SEWER SERVICE) FOR THE CITY OF PLEASANTON

JOB NO. JAN1428
DATE 6.20.14
DESIGNED BY: AMR
DRAWN BY: GLL
CHECKED BY: AMR
PAGE 1 OF 3

REVISIONS		
NO.	DESCRIPTION	DATE
1	OFF CUTS REMOVED	02/27/15

PLEASANTON

TEXAS

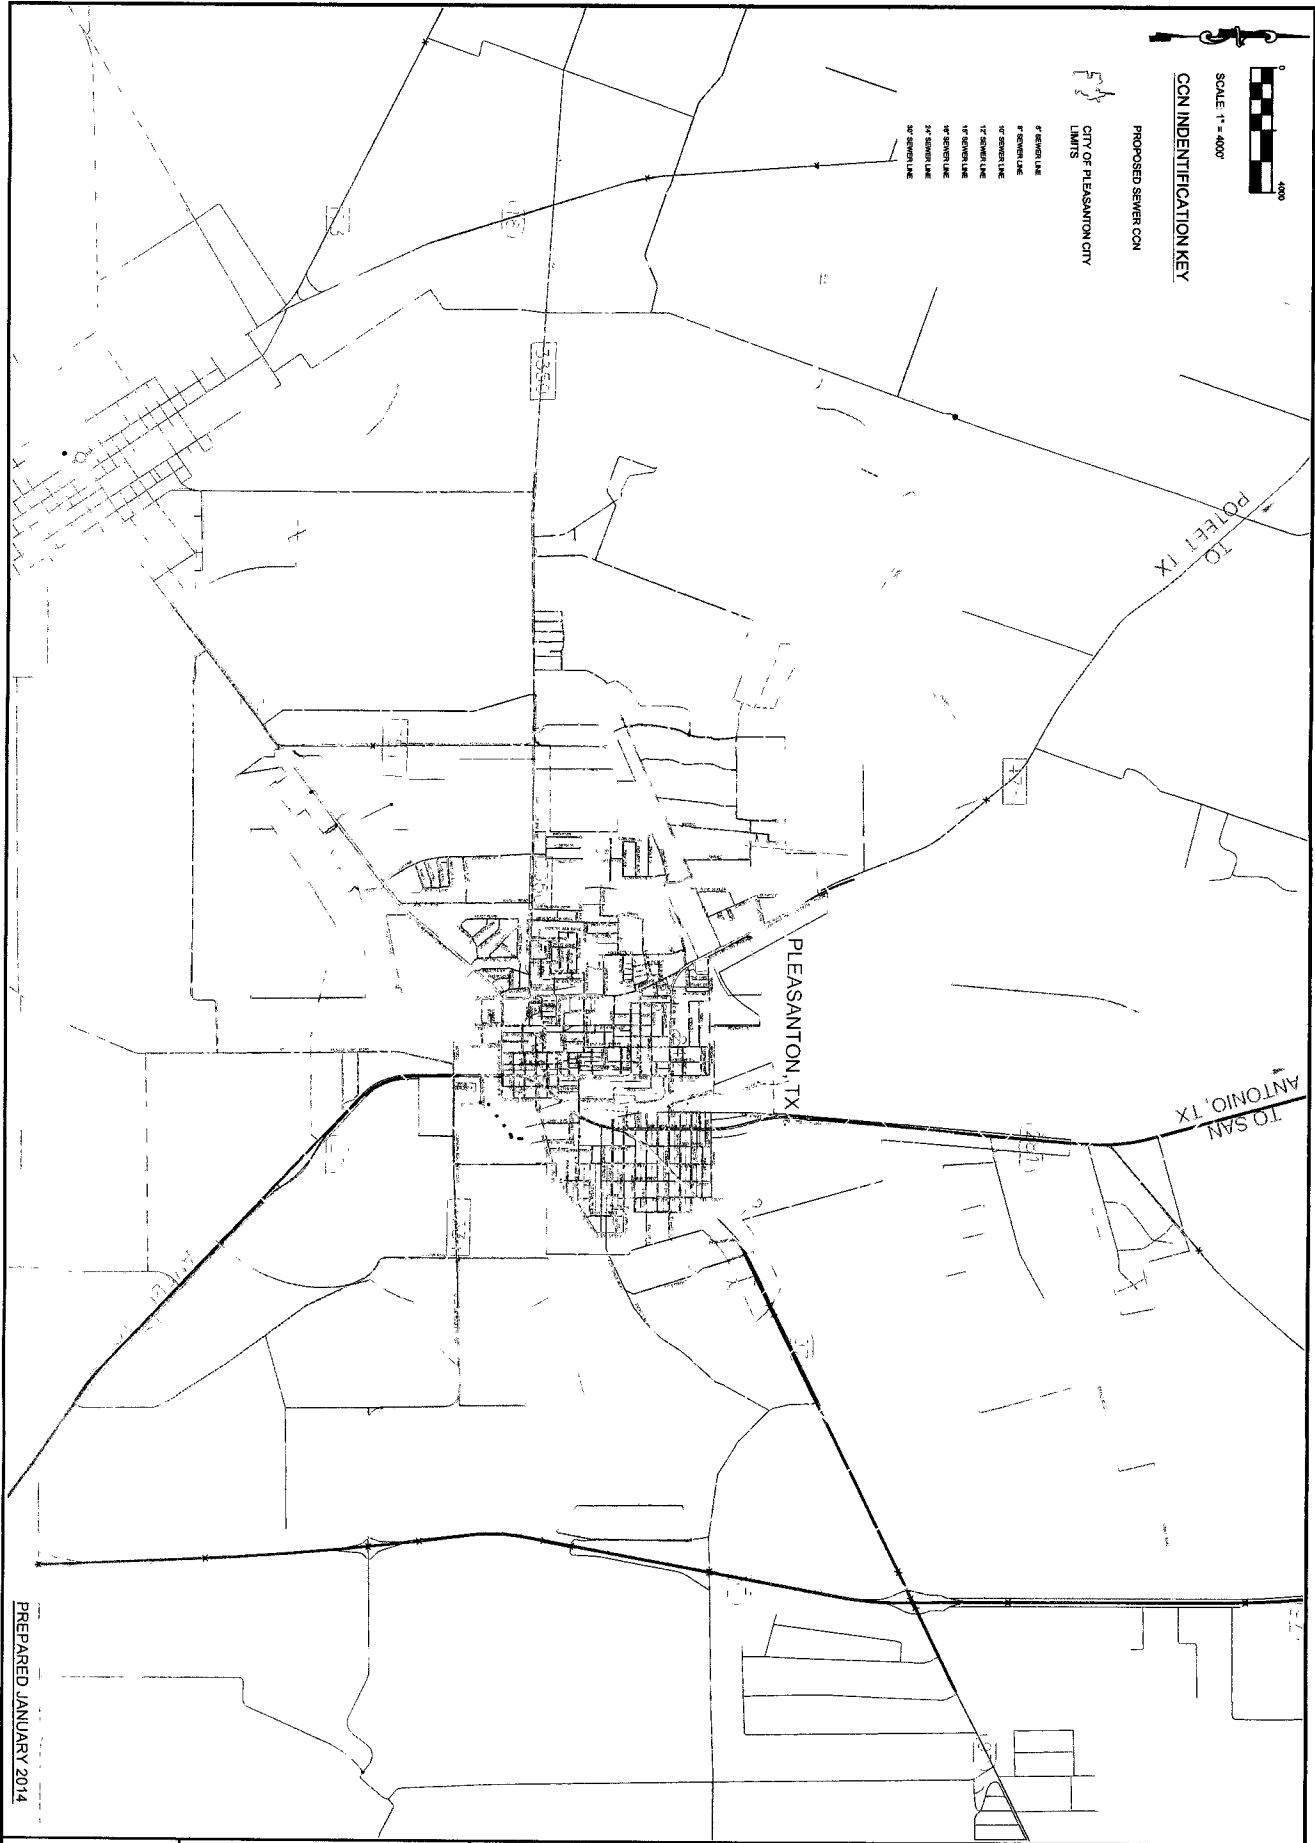

0
 400
 SCALE 1" = 400'
 CCN IDENTIFICATION KEY
 PROPOSED SEWER CCN
 CITY OF PLEASANTON CITY LIMITS

- 8" SEWER LINE
- 12" SEWER LINE
- 18" SEWER LINE
- 24" SEWER LINE
- 30" SEWER LINE

PREPARED JANUARY 2014

JOB NO. JN1742
 DATE 1/20/14
 DESIGNED BY ANR
 DRAWN BY GLL
 CHECKED BY ANR
 PAGE 3 OF 3


KLEIN & COPE
ENGINEERING
INC.
 CIVIL • MUNICIPAL • ENVIRONMENTAL ENGINEERS
 8811 30TH LANE, SUITE 100, HOUSTON, TEXAS 77017
 (281) 858-7070 FAX (281) 858-7076
 TEXAS REGISTRATION # P-10078

FACILITIES MAP - SEWER
PROPOSED CCN (SEWER SERVICE) FOR THE CITY OF PLEASANTON

REVISIONS		
NO.	DESCRIPTION	DATE
1	OPT OUTS REMOVED	02/27/15

PLEASANTON

TEXAS